

STATE ENGINEER
Salem, Oregon

YAMH

Well Record

STATE WELL NO. 5/4W-28C
COUNTY Yamhill
APPLICATION NO. GR-3465


7149

OWNER: A. J. Stone
MAILING ADDRESS: Route 1, Box 240

LOCATION OF WELL: Owner's No.
CITY AND STATE: Amity, Oregon

NE 1/4 NW 1/4 Sec. 28 T. 5 N. S., R. 4 E. W., W.M.

Bearing and distance from section or subdivision
corner 130 feet North and 70 feet East of the
SW Corner, Benjamin S. Burch DLC

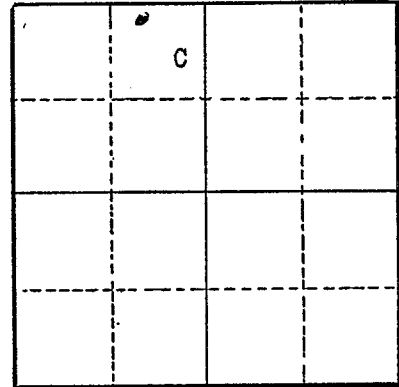

Section 28

Altitude at well 220 feet

TYPE OF WELL: Drilled Date Constructed July 1952

Depth drilled 65 feet Depth cased 65 feet

CASING RECORD:

6-inch casing set from surface to 65 feet

FINISH:

Perforated casing set from 60 feet to 65 feet

AQUIFERS:

WATER LEVEL:

64 feet

PUMPING EQUIPMENT: Type Universal-Deep Well Jet H.P.
Capacity 40 G.P.M.

WELL TESTS:

Drawdown ft. after hours 15 G.P.M.
Drawdown ft. after hours G.P.M.

USE OF WATER Irrigation Temp. °F. 19

SOURCE OF INFORMATION GR-4051

DRILLER or DIGGER Wilcox Drilling and Pump Co. McMinnville, Oregon

ADDITIONAL DATA:

Log (NA) Water Level Measurements Chemical Analysis Aquifer Test

REMARKS: