

STATE ENGINEER
Salem, Oregon

YAMH Well Record


7/63

STATE WELL NO. 5/AW-2900
COUNTY Yamhill
APPLICATION NO. CR-47A

OWNER: Amity-Gaston Nut Growers MAILING ADDRESS: Amity, Ore.
LOCATION OF WELL: Owner's No. # 2 CITY AND STATE: _____

SW 1/4 NE 1/4 Sec. 29 T. 5 S., R. 9 W., W.M.

Bearing and distance from section or subdivision corner Part of John Watt D.L.C. Notification #1273, Cl. #73 & part of Enos Williams D.L.C. Notification #1251, Cl. #45

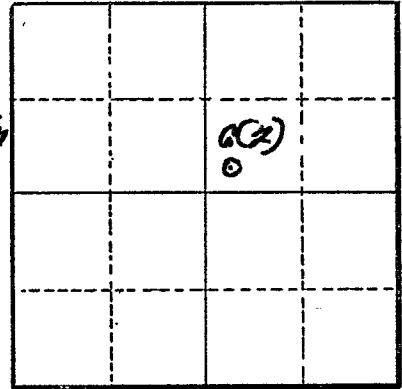

Section 29

Altitude at well 133

TYPE OF WELL: drilled Date Constructed Aug '45
Depth drilled 45 Depth cased 45

CASING RECORD:
6 inch

FINISH:

AQUIFERS:

WATER LEVEL:

15

PUMPING EQUIPMENT: Type F.F. Meyers Jet H.P. 1
Capacity 15 G.P.M.

WELL TESTS:
Drawdown bottom ft. after _____ hours 20 G.P.M.
Drawdown _____ ft. after _____ hours _____ G.P.M.

USE OF WATER industrial Temp. _____ °F. _____, 19.

SOURCE OF INFORMATION CR-47A
DRILLER or DIGGER Meeker Drilling Co.; Dundee Ore.

ADDITIONAL DATA:
Log X Water Level Measurements _____ Chemical Analysis _____ Aquifer Test _____

REMARKS:

