

STATE ENGINEER
Salem, Oregon

YAMH Well Record

STATE WELL NO. *5/4w-2906*
COUNTY *Yamhill*
APPLICATION NO. *G.P.-474*

7164

Growers

OWNER: *Amity-Gaston Nut*


MAILING ADDRESS:

LOCATION OF WELL: Owner's No. *# 1*

CITY AND STATE: *Amity, Ore*

SW 1/4 *NE* 1/4 Sec. *29* T. *5* S., R. *4* W., W.M.

Bearing and distance from section or subdivision corner *Part of John Warr D.C. Notification # 1273, Cl. # 73 ft part of Enos Williams D.C. Notification # 1251, Cl. # 45*

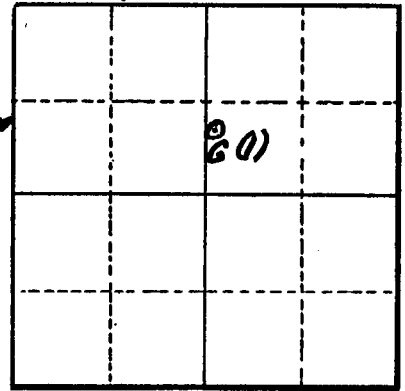

Altitude at well *158*

TYPE OF WELL: *drilled* Date Constructed *July '92*

Depth drilled *78* Depth cased *78*

Section *29*

CASING RECORD:

6 inch

FINISH:

AQUIFERS:

WATER LEVEL:

35

PUMPING EQUIPMENT: Type *F. E. Meyers jet* H.P. *2*
Capacity *25* G.P.M.

WELL TESTS:

Drawdown ft. after hours G.P.M.
Drawdown ft. after hours G.P.M.

USE OF WATER *industrial* Temp. °F., 19.....

SOURCE OF INFORMATION *G.P.-474*
DRILLER or DIGGER *Marion West, Salem, Ore.*

ADDITIONAL DATA:

Log Water Level Measurements Chemical Analysis Aquifer Test

REMARKS:

