

YAMH
7365


Well Record

OWNER: Herman E. Wood MAILING ADDRESS: Route 1, Box 227

LOCATION OF WELL: Owner's No. _____ CITY AND STATE: McMinnville, Oregon

SE 1/4 NE 1/4 NE 1/4 Sec. 24 T. 5 S., R. 5 W., W.M.

Bearing and distance from section or subdivision corner Being part of the John Jeffies DLC

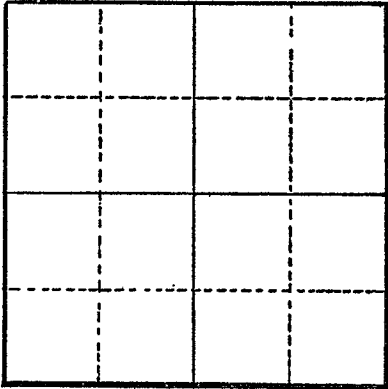

Section _____

Altitude at well _____

TYPE OF WELL: drilled Date Constructed 1952

Depth drilled 22' Depth cased _____

CASING RECORD:

18"

FINISH:

AQUIFERS:

clay and gravel

WATER LEVEL:

6'

PUMPING EQUIPMENT: Type Gould 2 1/2" H.P. 10
Capacity 250 G.P.M.

WELL TESTS:

Drawdown 15 ft. after _____ hours pumping 200 G.P.M.

Drawdown _____ ft. after _____ hours _____ G.P.M.

USE OF WATER Irrigation Temp. _____ °F. _____, 19_____

SOURCE OF INFORMATION GR-3182

DRILLER or DIGGER _____

ADDITIONAL DATA:

Log X Water Level Measurements _____ Chemical Analysis _____ Aquifer Test _____

REMARKS:

clay 18 22
gravel 4