

STATE ENGINEER  
Salem, Oregon

YAMH

# Well Record

STATE WELL NO. 5/5W-24D  
COUNTY Yamhill  
APPLICATION NO. GR-3440

7366

OWNER: Herman E. Wood


MAILING ADDRESS: Route 1, Box 227

LOCATION OF WELL: Owner's No. \_\_\_\_\_

CITY AND STATE: McMinnville, Oregon

SW  $\frac{1}{4}$  NW  $\frac{1}{4}$  NW  $\frac{1}{4}$  Sec. 24 T. 5 ~~N.~~ S., R. 5 ~~E.~~ W., W.M.

Bearing and distance from section or subdivision corner 4220' W. and 2520' S.

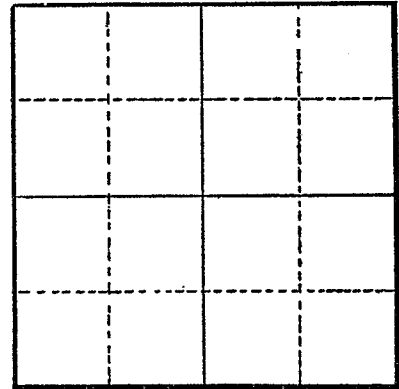

Section \_\_\_\_\_

Altitude at well \_\_\_\_\_

TYPE OF WELL: drilled Date Constructed 1938

Depth drilled 28' Depth cased \_\_\_\_\_

### CASING RECORD:

12"

### FINISH:

slots in casing made with perforator from 18' to 28'

### AQUIFERS:

clay and gravel

### WATER LEVEL:

21'

PUMPING EQUIPMENT: Type Gould 2 1/2" H.P. 10  
Capacity 250 G.P.M.

### WELL TESTS:

Drawdown 15 ft. after \_\_\_\_\_ hours pumping 200 G.P.M.  
Drawdown \_\_\_\_\_ ft. after \_\_\_\_\_ hours \_\_\_\_\_ G.P.M.

USE OF WATER Irrigation Temp. \_\_\_\_\_ °F. \_\_\_\_\_, 19 \_\_\_\_\_

SOURCE OF INFORMATION GR-3181

DRILLER or DIGGER \_\_\_\_\_

### ADDITIONAL DATA:

Log X Water Level Measurements \_\_\_\_\_ Chemical Analysis \_\_\_\_\_ Aquifer Test \_\_\_\_\_

### REMARKS:

clay  
gravel

21        7  
7