

STATE ENGINEER
Salem, Oregon

YAMH

OBSERVATION WELL

Well Record

STATE WELL NO. 6/3W-4D1
COUNTY Yamhill
APPLICATION NO. GR-1496

7735 GR- 1446

OWNER: Lloyd L. Lind J. A. BATZ MAILING ADDRESS: Rt. 1, Box 605

LOCATION OF WELL: Owner's No. #2 CITY AND STATE: Salem, Oregon

NW 1/4 NW 1/4 Sec. 4 T. 6 S., R. 3 W., W.M.

Bearing and distance from section or subdivision

corner N89°25'E. 25.68 ch. thence N. 9° E. 26 ch. thence


E. 55.835 ch. from SW cor. Wm. Miller

DIC. #59

Altitude at well 170'

TYPE OF WELL: Drilled Date Constructed 1954

Depth drilled 104' Depth cased 104'

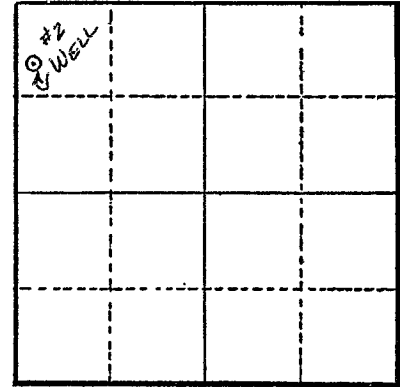

Section 4

CASING RECORD:

10"

FINISH:

Perforated from 86 to 104 ft.

AQUIFERS:

WATER LEVEL:

42'

PUMPING EQUIPMENT: Type F. M. 4" x 5" turbine H.P. 20

Capacity 360 G.P.M.

WELL TESTS:

Drawdown 27 ft. after 360 hours G.P.M.

Drawdown ft. after hours G.P.M.

USE OF WATER Irrigation Temp. °F., 19

SOURCE OF INFORMATION GR Record

DRILLER or DIGGER J. T. Miller

ADDITIONAL DATA:

Log Water Level Measurements Chemical Analysis Aquifer Test

REMARKS:

Log: Surface 0 to 3 ft.
Gray, sandy clay 3 to 23 ft.
Sand 23 to 80 ft.
Sand & gravel 80 to 104 ft.

Irrigation of 87 acres.