

7736


GR- 1447

OWNER: Lloyd L. Lind Mailing ADDRESS: Rt. 1, Box 605

LOCATION OF WELL: Owner's No. #1 CITY AND STATE: Salem, Oregon

NW 1/4 NW 1/4 Sec. 4 T. 6 S. R. 3 W., W.M.

Bearing and distance from section or subdivision
corner N. 89° 25' E. 25.68 ch., thence N. 9° E. 26.007 ch.
thence East 66.441 ch. from SW cor. D.L.C. #59.

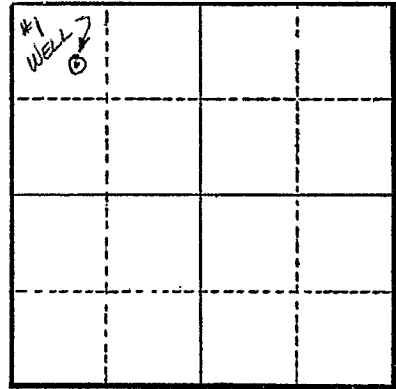

Section 4

Altitude at well

TYPE OF WELL: Drilled Date Constructed 1947

Depth drilled 84' Depth cased 84'

CASING RECORD:

6" from 1' to 84'

FINISH:

AQUIFERS:

WATER LEVEL:

48'

PUMPING EQUIPMENT: Type Jacuzzi jet H.P. 5
Capacity 60 G.P.M.

WELL TESTS:

Drawdown ft. after hours G.P.M.
Drawdown ft. after hours G.P.M.

USE OF WATER Irrigation Temp. °F., 19

SOURCE OF INFORMATION GR Record

DRILLER or DIGGER J. T. Miller

ADDITIONAL DATA:

Log Water Level Measurements Chemical Analysis Aquifer Test

REMARKS:

Log: Surface 0 to 3 ft.
Gray, sandy clay 3 to 23 ft.
Sand 23 to 80 ft.
Sand & gravel 80 to 84 ft.

Irrigation of 87 acres.