

STATE ENGINEER  
Salem, Oregon

# Well Record

STATE WELL NO. 6/3W-6H  
COUNTY Yamhill  
APPLICATION NO. GR-3131

**YAMH**  
7749

OWNER: Reuben Reist and Hilda Reist


MAILING ADDRESS: Route 1, Box 497

LOCATION OF WELL: Owner's No. \_\_\_\_\_

CITY AND STATE: Salem, Oregon

SE 1/4 NE 1/4 Sec. 6 T. 6 ~~N~~ S, R. 3 ~~E~~ W, W.M.

Bearing and distance from section or subdivision corner 350' W and 1370' S.

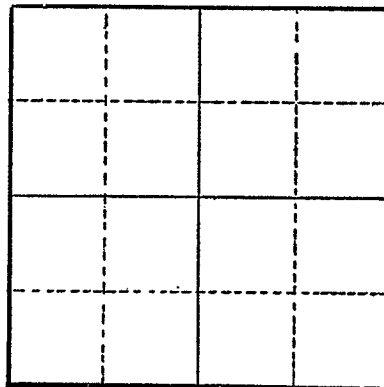

Section .....

Altitude at well .....

TYPE OF WELL: Drilled Date Constructed 1953

Depth drilled 120' Depth cased 65'

CASING RECORD:

6"

FINISH:

Lower part of well has no casing

AQUIFERS: Surface

Water rock

Clay and Boulders

WATER LEVEL:

40'

PUMPING EQUIPMENT: Type Submersible Fairbanks Morse H.P. 2

Capacity 40 G.P.M.

WELL TESTS:

Drawdown 30 ft. after \_\_\_\_\_ hours pumping 30 G.P.M.

Drawdown 60 ft. after \_\_\_\_\_ hours pumping 40 G.P.M.

USE OF WATER Irrigation Temp. \_\_\_\_\_ °F. \_\_\_\_\_, 19\_\_\_\_\_

SOURCE OF INFORMATION GR-2936

DRILLER or DIGGER T. Miller

ADDITIONAL DATA:

Log X Water Level Measurements \_\_\_\_\_ Chemical Analysis \_\_\_\_\_ Aquifer Test \_\_\_\_\_

REMARKS:

Surface	0	18
surface water	18	23
red clay & boulders		
	23	64
rock with water	64	120