

STATE ENGINEER
Salem, Oregon

YAMH
7793

Well Record

STATE WELL NO. 6/SW-6K0
COUNTY Yamhill
APPLICATION NO. GR-40

OWNER: Hugh G. Shields

MAILING
ADDRESS:

LOCATION OF WELL: Owner's No. #2


CITY AND
STATE:

Sheridan, Oregon

NW 1/4 SE 1/4 Sec. 6 T. 6 N. S., R. 5 W., W.M.

Bearing and distance from section or subdivision

corner 475 feet south and 720 feet east
from center of section 6.

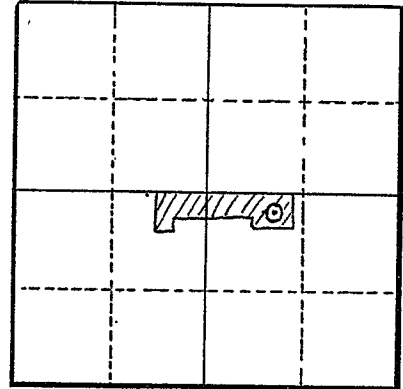

Section 6

Altitude at well 230 feet Interpolated

TYPE OF WELL: Drilled Date Constructed May 1954

Depth drilled 20' Depth cased 20'

CASING RECORD:

18 — inch concrete tile set from 0 to 20 feet.

FINISH:

None

AQUIFERS:

Gravel from 7 to 20 feet.

WATER LEVEL:

3 feet below land surface. May 1954

PUMPING EQUIPMENT: Type Wisconsin
Capacity 50 G.P.M.

H.P. 3

WELL TESTS:

Drawdown — ft. after — hours — G.P.M.

Drawdown — ft. after — hours — G.P.M.

USE OF WATER Irrigation and Domestic 15ac Temp. — °F., 19—

SOURCE OF INFORMATION Registration Statement GR-40

DRILLER or DIGGER Walter Irwin, Amity Oregon

ADDITIONAL DATA:

Log ✓ Water Level Measurements ✓ Chemical Analysis — Aquifer Test —

REMARKS:

Log: clay 0-7' 7 feet thick
gravel 7-20' 13' " "
shale 20'- bottom of hole.