

STATE ENGINEER
Salem, Oregon

YAMH

Well Record

STATE WELL NO. 65W-6 L (1)
COUNTY Yamhill
APPLICATION NO. GR-40

OWNER: Hugh G. Shields 779.1

MAILING ADDRESS:


LOCATION OF WELL: Owner's No. #1

CITY AND STATE:

Sheridan, Oregon

NE 1/4 SW 1/4 Sec. 6 T. 6 S., R. 5 W., W.M.

Bearing and distance from section or subdivision corner 500 feet south and 130 feet from center of section 6.

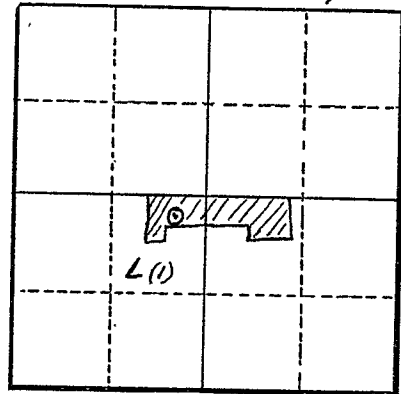

Section 6

Altitude at well 230 feet Interpolation

TYPE OF WELL: Drilled Date Constructed Nov. 1952

Depth drilled 14' Depth cased 14'

CASING RECORD:

18-inch concrete tile set from 0 to 14 feet.

FINISH:

None

AQUIFERS:

Gravel, from 8 to 14 feet.

WATER LEVEL:

3 feet below land surface, Nov. 1952

PUMPING EQUIPMENT: Type Fairbanks Morse - centrifugal H.P. 3
Capacity 50 G.P.M.

WELL TESTS:

Drawdown Not tested ft. after _____ hours _____ G.P.M.

Drawdown _____ ft. after _____ hours _____ G.P.M.

USE OF WATER Irrigation & Domestic 15 acres Temp. _____ °F. _____, 19____

SOURCE OF INFORMATION Registration Statement GR-40

DRILLER or DIGGER Walter Irwin, Amity, Oregon

ADDITIONAL DATA:

Log Water Level Measurements Chemical Analysis _____ Aquifer Test _____

REMARKS:

Log: clay, wapato 0-6' 6 ft. thick
gravel 6-14' 8" "